





1	ISSUED FOR BE ADDENDUM NO.	2025.02.26	YKM
	01		
	ISSUED FOR TENDER	2025.02.18	YKM
No.	Revision	Date	By

- Drawing Notes
- All drawings, plans, models, designs, specifications and other documents prepared by Read Jones Christoffersen Ltd. ("RJC") and used in connection with this project are instruments of service for the work shown in them (the "Work") and as such are and remain the property of RJC whether the Work is executed or not, and RJC reserves the copyright in them and in the Work executed from them, and they shall not be used for any other work or project.
  - These drawings are "design drawings" only. They may not be suitable for use as shop drawings. Use of these drawings as base drawings for "shop drawings" is not permitted unless written permission containing certain conditions and limitations is obtained from RJC. The work "as constructed" may vary from what is shown on these drawings.
  - Use of these drawings is limited to that identified in the Issued/Revision column. Do not construct from these drawings unless marked "Issued for Construction" by RJC in the Issued/Revision column, and then only for the parts noted. The drawings shall not be used for "pricing", "costing" or "tender" unless so indicated in the Issued/Revisions column. "Pricing" or "Costing" drawings are not complete and any prices based on such drawings must allow for this.

Seal



EGBC Permit to Practice No. 1002503


Project Name  
**POIRIER SPORTS AND  
LEISURE COMPLEX -  
CHLORINE VENTILATION**

633 POIRIER SREET, COQUITLAM, BC

Sheet Title  
**BUILDING ENVELOPE  
DETAILS**

Drawn By **JLI** Scale **As indicated**  
Designed By **YKM** Date **FEBRUARY 18, 2025**  
RJC Project Number **VAN.137337.0003**

Sheet Number **R-2.1** Revision **1**

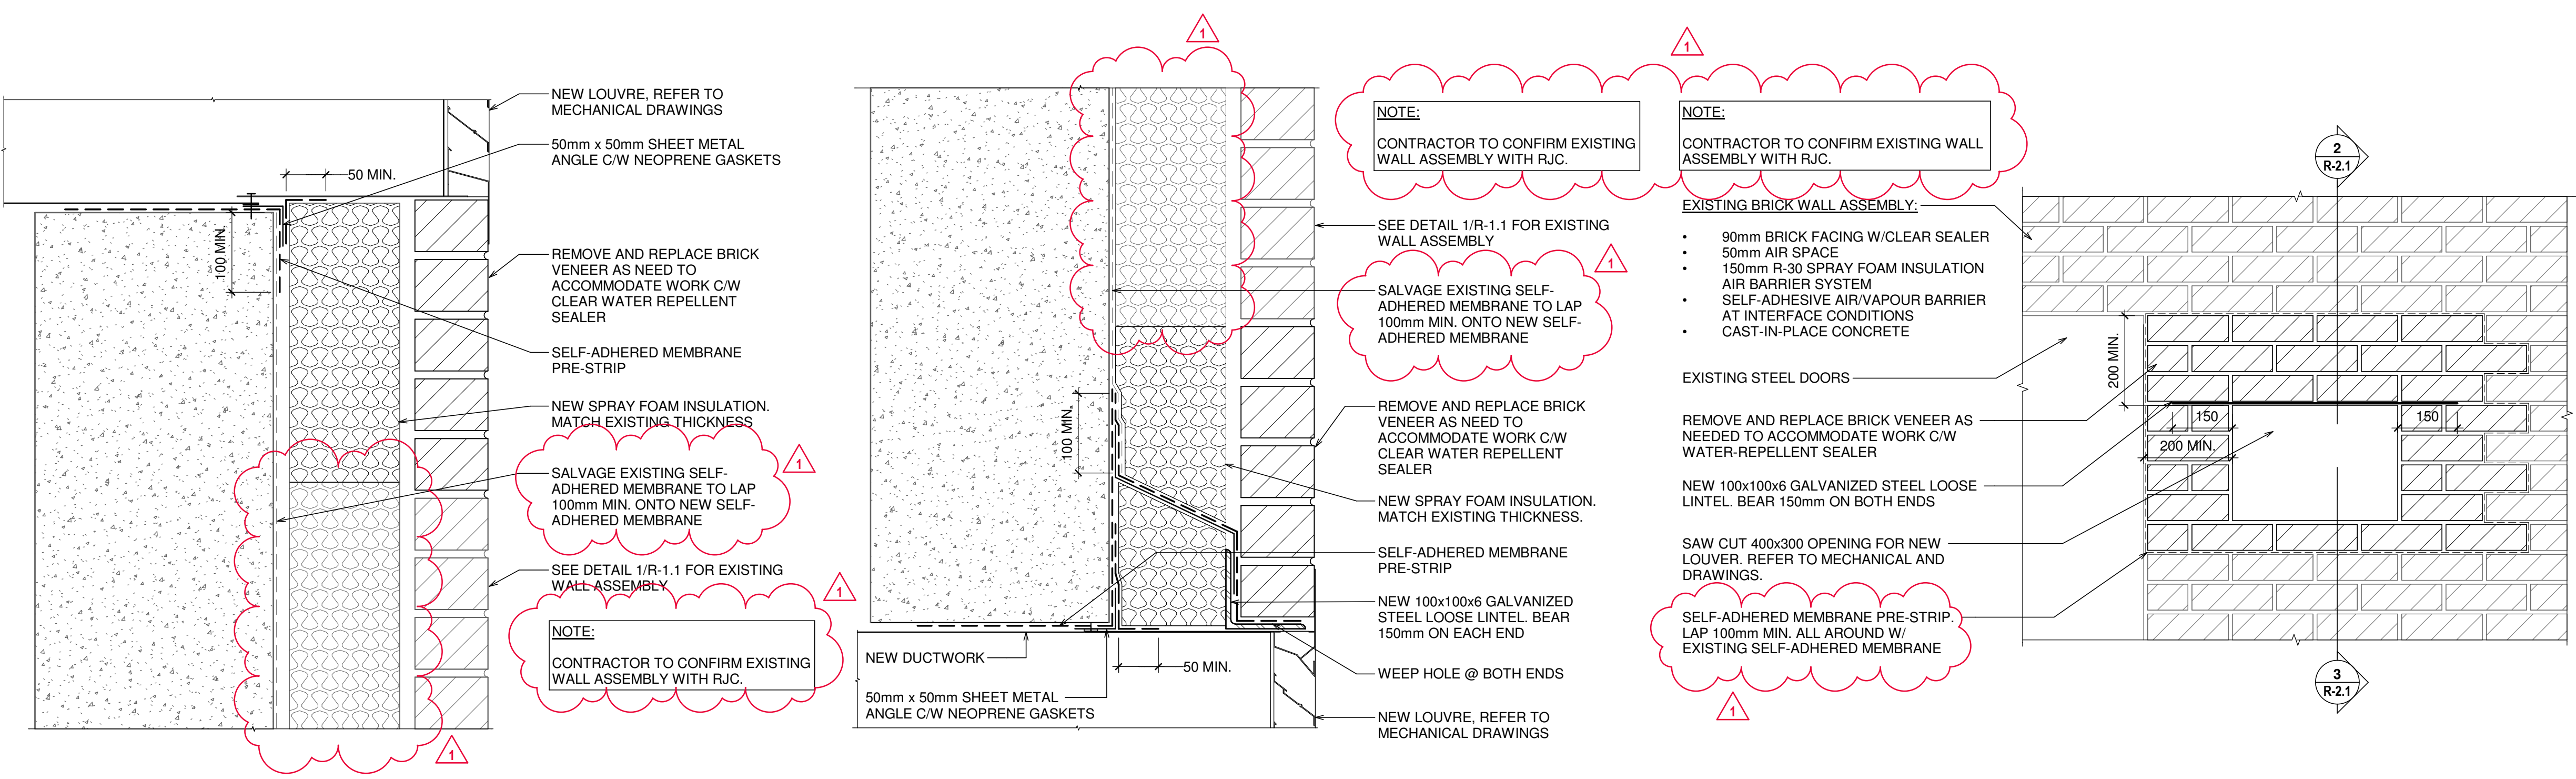

- NOTES:**
1. NEW ROOF ASSEMBLY TO MATCH EXISTING. CONFIRM ROOF ASSEMBLY WITH RJC PRIOR TO INSTALLATION.
  2. REFER TO ROOFING SPECIFICATIONS FOR APPROVED PRODUCTS.
  3. PREPARE ALL SURFACES TO RECEIVE MEMBRANE TO MANUFACTURER'S WRITTEN INSTRUCTION.

