

GENERAL NOTES

- ALL CONSTRUCTION AND MATERIALS SHALL BE IN ACCORDANCE WITH:
 - CITY OF COQUITLAM SUBDIVISION AND DEVELOPMENT SERVING BYLAW NO. 3558, 2003 AS AMENDED MARCH 2016 AND THE APPLICABLE CITY OF COQUITLAM SUPPLEMENTARY SPECIFICATIONS AND DETAILED DRAWINGS TO MMCD 2009 EDITION.
 - APPLICABLE CONTRACT DOCUMENTS AND ALL SPECIFICATIONS REFERENCED THEREIN.
 - MASTER MUNICIPAL CONSTRUCTION DOCUMENTS 2009 PLATINUM EDITION.
 - THE CONTRACTOR SHALL MAINTAIN ON SITE COPIES OF THE ABOVE DOCUMENTS AND SHALL ENSURE THAT ALL TRADES ARE THOROUGHLY FAMILIAR WITH THE APPLICABLE SECTIONS OF THESE DOCUMENTS.
- ALL WORK SHALL CONFORM TO THE CONSTRUCTION STANDARDS SPECIFIED IN THE SUBDIVISION AND DEVELOPMENT SERVICES BYLAW AND SHALL PASS THE INSPECTION OF THE CITY OF COQUITLAM OPERATIONS DEPARTMENT. CONTACT SENIOR ENGINEERING INSPECTOR MRL LARRY HOVEY AT 604-927-4319, 72 HOURS PRIOR TO CONSTRUCTION.
- THE CONTRACTOR SHALL ENSURE THAT ALL APPROVALS/PERMITS REQUIRED FOR THE PROPOSED WORKS HAVE BEEN OBTAINED FROM ALL AUTHORITIES AND AGENCIES PRIOR TO COMMENCEMENT OF WORK.
- EXISTING UNDERGROUND SERVICES SHOWN ARE BASED ON AS-CONTRACTED DRAWINGS PROVIDED BY THE CITY OF COQUITLAM. EXISTING UTILITIES SHOWN ARE BASED ON DRAWINGS PROVIDED BY THE RESPECTIVE UTILITY COMPANIES. THE CONTRACTOR SHALL EXPOSE AND VERIFY THE LOCATION OF EXISTING SERVICES AND UTILITIES UNDER THE SUPERVISION OF THE APPROPRIATE AUTHORITY PRIOR TO CONSTRUCTION, AND NOTIFY THE ENGINEER OF ANY DISCREPANCIES, CONFLICTS OR OMISSIONS. THE CITY OF COQUITLAM AND THE UTILITY COMPANIES CANNOT BE HELD LIABLE FOR ANY DISCREPANCIES, CONFLICTS OR OMISSIONS.
- THE CONTRACTOR SHALL TAKE EXTREME CARE WHEN WORKING NEAR OR AROUND EXISTING SERVICES, ANY DISTURBANCE TO THESE SERVICES SHALL BE REPLACED OR MADE GOOD TO THE SATISFACTION OF THE CITY OF COQUITLAM OR THE OWNER OF THE UTILITY.
- DISTURBANCE TO ANY LANDSCAPING OR IMPROVEMENT SHALL BE RESTORED BY THE CONTRACTOR TO THE SATISFACTION OF THE CITY OF COQUITLAM. IN SOME CASES THE CITY OF COQUITLAM MAY REQUIRE THE CONTRACTOR TO OBTAIN WRITTEN ACCEPTANCE OF THE RESTORATION FROM THE AFFECTED PROPERTY OWNERS.
- ALL MONUMENTS, POSTS OR IRON PINS DISTURBED OR DESTROYED SHALL BE REPLACED AND RESURVEYED AT THE CONTRACTOR'S EXPENSE AND TO THE CITY OF COQUITLAM'S SATISFACTION.
- ALL EXISTING LIVE SERVICES SHALL BE MAINTAINED OPERATIONAL DURING CONSTRUCTION.
- WORK REFERENCED AS 'BY DEVELOPER' SHALL BE CARRIED OUT BY THE CONTRACTOR. WORK REFERENCED TO AS 'BY BUILDER' WILL BE CARRIED OUT BY OTHERS.
- STORM AND SANITARY SEWERS SHALL BE VIDEO INSPECTED ONCE DURING THE PERIOD BETWEEN COMPLETION OF CONSTRUCTION AND THE END OF MAINTENANCE PERIOD AT THE DEVELOPERS EXPENSE. THE CONTRACTOR SHALL PROVIDE THE CITY WITH ONE COPY OF THE VIDEO AND DATA REPORT.
- ALL EXISTING SERVICES THAT REQUIRE CAPPING (TEMPORARY OR PERMANENT) MUST BE CAPPED BY THE ENGINEERING & PUBLIC WORKS DEPARTMENT OF THE CITY OF COQUITLAM AT THE DEVELOPERS COST. PLEASE CONTACT MS. DEBBIE MURRAY AT 604-927-3508 TO MAKE NECESSARY ARRANGEMENTS AND PAYMENT TO GET THE SERVICES CAPPED.

LEGEND OF SYMBOLS

EXISTING	PROPOSED	EXISTING	PROPOSED

Edge of pavement	Hydrant	Sanitary service	Hydro Guy Wire

No.	Date	By	Revisions
1	2021-05-05	S.U.	RECORD DRAWING
2	2020-06-02	B.D.	ROAD B REVISED
3	2020-03-28	B.D.	ISSUED FOR CONSTRUCTION
4	2020-11-21	B.D.	RE-ISSUED FOR SERVING AGREEMENT
5	2019-12-12	B.D.	RE-ISSUED FOR SERVING AGREEMENT
6	2019-11-01	B.D.	ISSUED FOR SERVING AGREEMENT
7	2019-08-15	B.D.	RE-ISSUED FOR CITY REVIEW

The seal and signature of the undersigned on this drawing certifies that the design information contained in this drawing accurately reflects the original design and the material design changes made during construction, that were brought to the undersigned's attention. This drawing is intended to incorporate addendum change orders and other material design changes, but not necessarily all site instructions. The undersigned does not warrant or guarantee, nor accept any responsibility for the accuracy or completeness of the as-constructed information supplied by others contained in this drawing, but does, by sealing and signing, certify that the as-constructed information, if accurate and complete, provides an as-constructed system which substantially complies in all material respects with the original design intent.

Design by: Date: **WSP** **WSP CANADA INC.**
 Drawn by: Date: **WSP** **4015-88 BUCHANAN STREET**
 Checked by: Date: **WSP** **NEW WESTMINSTER, B.C.**
 Approved by: Date: **WSP** **CANADA, V3L 3P5**
 (604) 273-1111

ACCEPTED FOR CONSTRUCTION Date: _____




Coquitlam
Engineering & Public Works
3000 Oxford Way, Coquitlam, B.C. V3B 7J2

Project: **MITCHELL TOWNHOMES**
 Scale: 1:500
 Sheet: **2 of 23**
 Eng. Project No: **16-110057 SD**
 Description: **KEY PLAN**



LEGAL DESCRIPTION
 LOTS 15616 PLAN 22154, AND LOTS 1306131 PLAN 67085; ALL OF SECTION 7, TOWNSHIP 40, N.W.D.

BENCHMARK
 SURVEY MONUMENT #774134, INTERSECTION OF ROCKLIN STREET AND BAYCREST AVENUE
 EL. = 53.28m



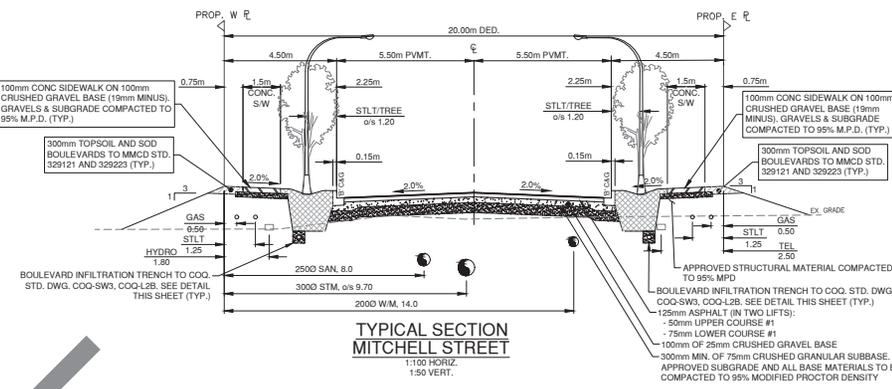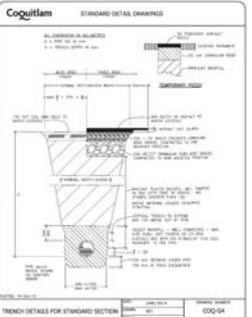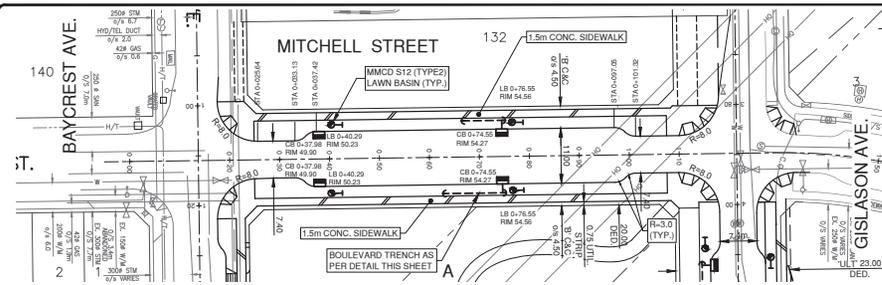

STATION	EAST GUTTERLINE	E&W GUTTERLINE (TYP.)	CENTRELINE ELEV.
46	47.57	48.88	47.57
47	48.33	49.14	48.33
48	49.22	50.16	49.22
49	50.27	51.34	50.16
50	51.45	52.54	51.34
51	52.65	53.74	52.54
52	53.85	54.92	53.74
53	55.03	56.07	54.92
54	56.08	57.01	56.07
55	57.01	57.55	57.01
56	57.48	58.03	57.48
57	58.03		58.03

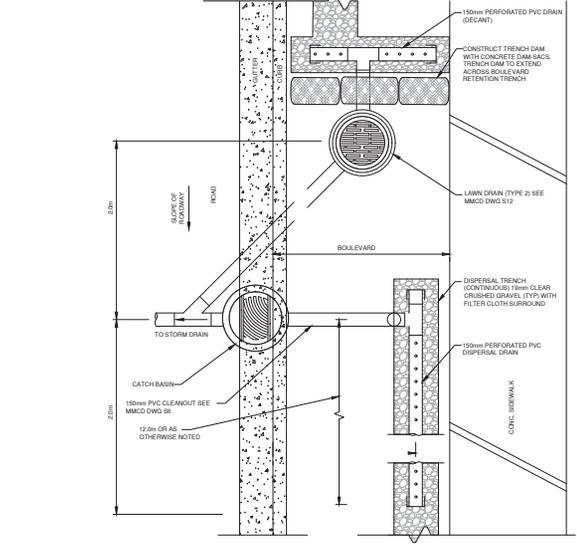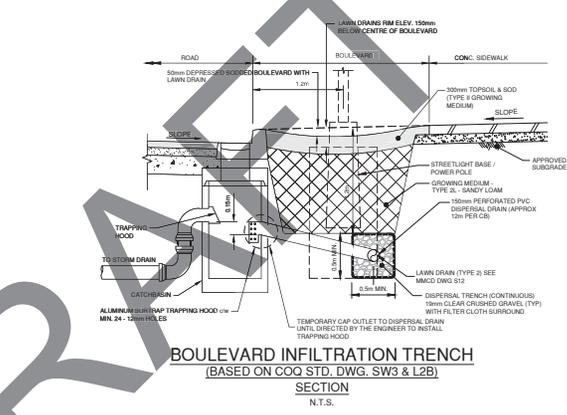

STATION	E&W GL ELEV.	CENTRELINE ELEV.
46	47.57	47.57
47	48.33	48.33
48	49.22	49.22
49	50.16	50.16
50	51.34	51.34
51	52.54	52.54
52	53.74	53.74
53	54.92	54.92
54	56.07	56.07
55	57.01	57.01
56	57.48	57.48
57	58.03	58.03

NOTES:

- SEE SHEET #2 FOR GENERAL NOTES.
- SEE SHEET #3 FOR ROADWORKS NOTES.
- SEE SHEETS #3 & #4 FOR CURB RETURNS.
- SEE SHEET #17 FOR CROSS SECTIONS.

LEGAL DESCRIPTION

LOTS 15&16 PLAN 22154, AND LOTS 130&131 PLAN 67085; ALL OF SECTION 7, TOWNSHIP 40, N.W.D.


BENCHMARK

SURVEY MONUMENT #774434, INTERSECTION OF ROCKLIN STREET AND BAYCREST AVENUE EL. = 53.258M

The seal and signature of the undersigned on this drawing certifies that the design information contained in this drawing accurately reflects the original design and the material design changes made during construction, that were brought to the undersigned's attention. This drawing is intended to incorporate addenda, change orders and other material design changes, but not necessarily all site instructions.


The undersigned does not warrant or guarantee, nor accept any responsibility for the accuracy or completeness of the as-constructed information supplied by others contained in this drawing, but does, by sealing and signing, certify that the as-constructed information, if accurate and complete, provides an as-constructed system which substantially complies in all material respects with the original design intent.

<p>Edge of pavement</p> <p>Watermain and valve</p> <p>Drainage sewer, MH</p> <p>Drainage ditch</p> <p>Sanitary sewer, MH</p> <p>Sanitary forcemain</p> <p>Gasmain and valve</p> <p>Hydro duct, MH</p> <p>Telephone duct, MN</p>	<p>Hydrovalve</p> <p>Water air valve</p> <p>Water blowoff</p> <p>Water service</p> <p>Catch basin, top inlet</p> <p>Catch basin, side inlet</p> <p>Catch basin, round</p> <p>Drainage service</p> <p>Drainage cleanout</p>	<p>Sanitary service</p> <p>Sanitary cleanout</p> <p>Utility pole/joint pole</p> <p>Utility pole with light</p> <p>Streetlight, down</p> <p>Streetlight, post top</p> <p>Comb signal pole</p> <p>Traffic signal pole</p> <p>Junction box</p>	<p>Hydro Guy Wire</p> <p>Hydro Hoist</p> <p>Vegetation Center</p> <p>Vegetation Dechlorus</p> <p>Vegetation Shrub</p> <p>Survey Traverse Hub</p> <p>Survey Iron Pin</p> <p>Survey Level Plug</p> <p>Survey Monument</p>	<p>1 2021-05-06 S U RECORD DRAWING</p> <p>H 2020-03-18 B D RE-ISSUED FOR CONSTRUCTION</p> <p>G 2020-03-06 B D ISSUED FOR CONSTRUCTION</p> <p>F 2020-01-21 B D RE-ISSUED FOR SERVICING AGREEMENT</p> <p>E 2019-12-12 B D RE-ISSUED FOR SERVICING AGREEMENT</p> <p>D 2019-11-01 B D ISSUED FOR SERVICING AGREEMENT</p> <p>C 2019-08-15 B D RE-ISSUED FOR CITY REVIEW</p>	<p>Design by Date</p> <p>DJR SEPT 2018</p> <p>Drawn by Date</p> <p>ED SEPT 2018</p> <p>Checked by Date</p> <p>GR APR 2019</p> <p>Approved by Date</p>	<p>WSP CANADA INC.</p> <p>401-55 HURONTARIO STREET</p> <p>NEW WESTMINSTER, B.C.</p> <p>CANADA V3A 5P5</p> <p>TEL: 604-661-1144 FAX: 604-226-5710</p>	<p>ACCEPTED FOR CONSTRUCTION</p> <p>Date:</p> <p>Manager of Development Servicing</p>	<p>Coquitlam</p> <p>Engineering & Public Works</p> <p>3000 Oxford Way, Coquitlam, B.C. V3B 7N2</p>	<p>Scale 1:500 Scale 1:50</p> <p>horiz. vert.</p> <p>Sheet 5 of 23</p> <p>Eng. Project No. 16-110057 SD</p>	<p>Project MITCHELL TOWNHOMES</p> <p>Description ROADWORKS MITCHELL STREET</p>
---	--	---	---	--	---	--	---	--	---	--

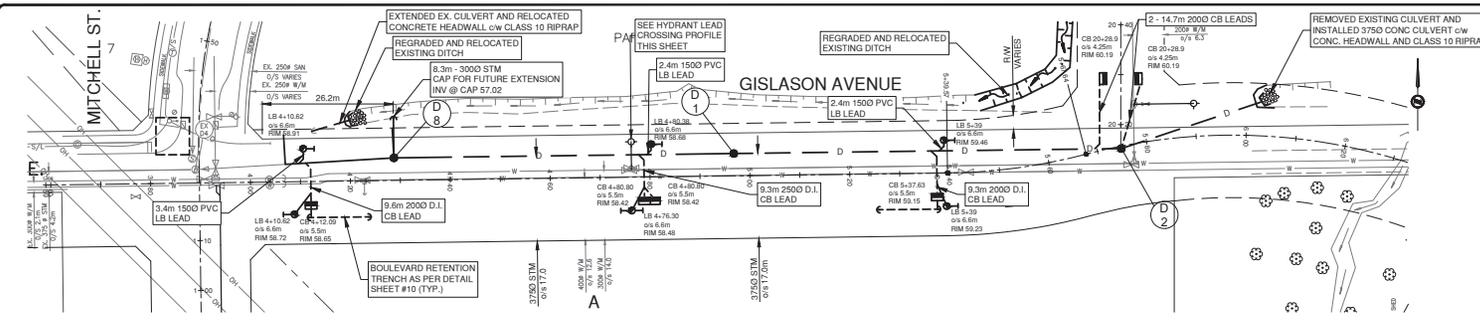

- ### STORM SEWER
- UNLESS OTHERWISE INDICATED STORM SEWER MATERIALS SHALL BE.
 - MAIN:
 - 250mmØ - PVC DR 35
 - 300mmØ - PVC DR 35 OR CONCRETE C14 CLASS 3
 - 375mmØ TO 675mmØ - CONCRETE C15 CLASS 3
 - CATCH BASIN LEADS:
 - SINGLE CB - 200mmØ PVC DR 35 (UNLESS OTHERWISE NOTED)
 - DOUBLE CB - 250mmØ PVC DR 35 (UNLESS OTHERWISE NOTED)
 - MANHOLES (PRECAST REINFORCED CONCRETE):
 - 1050mmØ - MAINS UP TO 450mmØ
 - 1200mmØ - MAINS 525mmØ AND 600mmØ
 - 1350mmØ - MAINS 675mmØ AND 750mmØ
 - 1500mmØ - MAINS 900mmØ TO 1050mmØ OR RISER MH
 - CATCH BASINS:
 - STANDARD SIDE INLET
 - 900mmØ PRECAST REINFORCED CONCRETE
 - MANHOLES SHALL BE INSTALLED AS PER MMCD STANDARD DRAWING S11. SIDE INLET CATCH-BASINS SHALL BE INSTALLED AS PER CITY OF COQUITLAM STANDARD DRAWING COO-S11A. CATCH BASIN RIM ELEVATIONS FOR STANDARD AND SIDE INLET CATCH BASINS SHALL BE SET 30mm BELOW FINISHED GRADE.
 - STANDARD CATCH BASINS SHALL BE INSTALLED AS PER MMCD STANDARD DRAWING S11. SIDE INLET CATCH-BASINS SHALL BE INSTALLED AS PER CITY OF COQUITLAM STANDARD DRAWING COO-S11A. CATCH BASIN RIM ELEVATIONS FOR STANDARD AND SIDE INLET CATCH BASINS SHALL BE SET 30mm BELOW FINISHED GRADE.
 - INSPECTION CHAMBERS SHALL BE INSTALLED FOR ALL CONNECTIONS AS PER MMCD STANDARD DRAWING S9 UNLESS OTHERWISE NOTED.
 - STORM CONNECTION TO BE 150mm DIA PVC UNLESS OTHERWISE NOTED.
 - TRENCHING SHALL BE AS PER CITY OF COQUITLAM STANDARD DRAWING COQ-G4.
 - ALL WYES TO BE MANUFACTURED.
 - TIE INTO EXISTING SEWERS TO BE PERFORMED BY CONTRACTOR AND WITNESSED BY THE MUNICIPAL INSPECTOR. 48 HOURS NOTICE REQUIRED.

The seal and signature of the undersigned on this drawing certifies that the design information contained in this drawing accurately reflects the original design and the material design changes made during construction, that were brought to the undersigned's attention. This drawing is intended to incorporate addenda, change orders and other material design changes, but not necessarily all site instructions. The undersigned does not warrant or guarantee, nor accept any responsibility for the accuracy or completeness of the as-constructed information supplied by others contained in this drawing, but does, by sealing and signing, certify that the as-constructed information, if accurate and complete, provides an as-constructed system which substantially complies in all material respects with the original design intent.

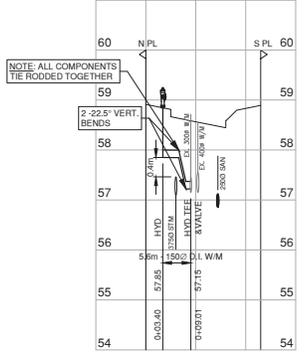


HYDRANT LEAD CROSSING
1:500 HORIZ.
1:50 VERT.

NOTES:
1. SEE SHEET #2 FOR GENERAL NOTES.

LEGAL DESCRIPTION
LOTS 15816 PLAN 22154, AND LOTS 1306131 PLAN 67085; ALL OF SECTION 7, TOWNSHIP 40, N.W.D.

BENCHMARK
SURVEY MONUMENT #774134, INTERSECTION OF ROCKLIND STREET AND BAYCREST AVENUE
E.L. = 53.258m

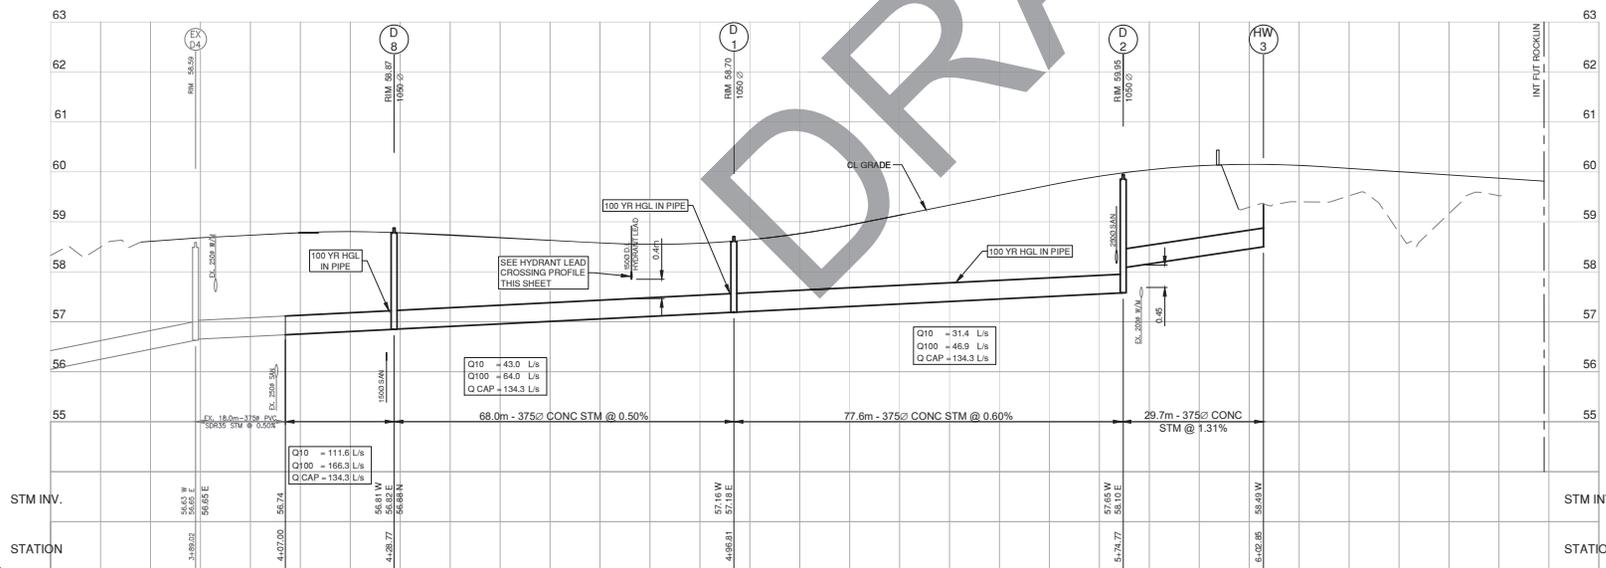

Symbol	Description	Symbol	Description
---	Edge of pavement	○	Hydrant
---	Watermain and valve	○	Water air valve
---	Drainage sewer, MH	○	Water blowoff
---	Drainage ditch	○	Water service
---	Sanitary sewer, MH	○	Catch basin, top inlet
---	Sanitary forcemain	○	Catch basin, side inlet
---	Gasmain and valve	○	Catch basin, round
---	Hydro duct, MH	○	Drainage service
---	Telephone duct, MH	○	Drainage cleanout
○	Sanitary service	○	Hydro Guy Wire
○	Sanitary cleanout	○	Hydro Risk
○	Utility pole/point pole	○	Vegetation Center
○	Utility pole with light	○	Vegetation Dechlorous
○	Streetlight, dual	○	Vegetation Shrub
○	Streetlight, post top	○	Survey Traverse Hub
○	Comb signal pole	○	Survey Iron Pin
○	Traffic signal pole	○	Survey Level Plug
○	Junction box	○	Survey Monument

Rev	Date	By	Revisions
1	2021-06-06	S.U.	RECORD DRAWING
2	2020-06-02	B.D.	ROAD B REVISED
3	2020-03-06	B.D.	ISSUED FOR CONSTRUCTION
4	2020-01-21	B.D.	RE-ISSUED FOR SERVICING AGREEMENT
5	2019-12-12	B.D.	RE-ISSUED FOR SERVICING AGREEMENT
6	2019-11-01	B.D.	RE-ISSUED FOR SERVICING AGREEMENT
7	2019-08-15	B.D.	RE-ISSUED FOR CITY REVIEW

Design by: WSP CANADA INC.
Date: SEPT 2018
Drawn by: ESD
Date: SEPT 2018
Checked by: Date: APR 2019
Date: APR 2019
Approved by: Date: _____


WSP CANADA INC.
400-46 RICHMOND STREET
NEW WESTMINSTER, B.C.
CANADA V3A 3P5
TEL: 604-681-1144 FAX: 604-626-5710
www.wsp.ca

ACCEPTED FOR CONSTRUCTION
Date: _____
Manager of Development Servicing

Coquitlam
Engineering & Public Works
3000 Oxford Way, Coquitlam, B.C. V3B 7N2

Scale: 1:500
Scale: 1:50
horiz. vert.
Sheet: 9 of 23
Eng. Project No: 16-110057 SD


Project: MITCHELL TOWNHOMES
Description: DRAINAGE GISLASON AVENUE

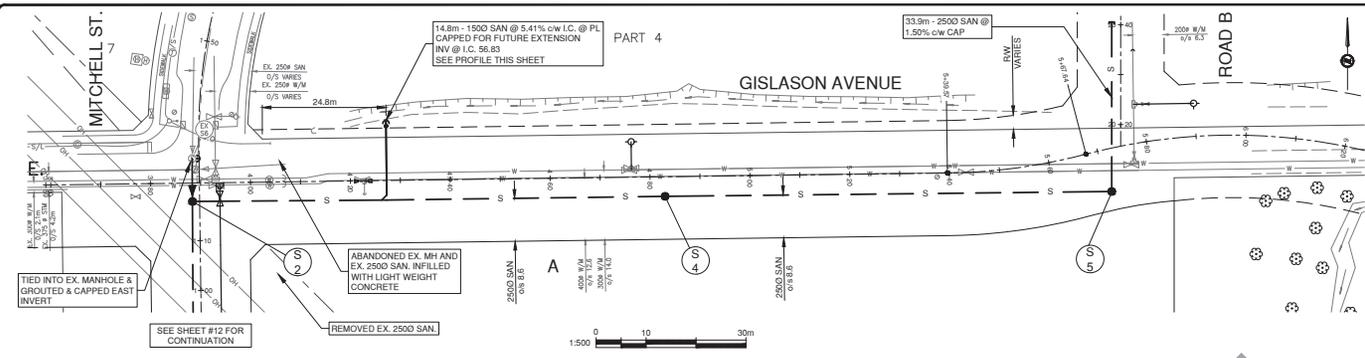




SANITARY SEWER

- UNLESS OTHERWISE INDICATED SANITARY SEWER MATERIALS SHALL BE:
 - MAINS: - PVC DR 35
 - SERVICE CONNECTIONS: 100mmØ AND 150mmØ - PVC DR 28
 - 200mmØ AND GREATER - PVC DR 35
 - MANHOLES: 1050mmØ - PRECAST REINFORCED CONCRETE
- MANHOLES SHALL BE INSTALLED AS PER MMCD STANDARD DRAWING S1 AND S2. BENCHING SHALL BE AS PER MMCD STANDARD DRAWING S3. MANHOLE FRAMES AND COVERS SHALL CONFORM TO CITY OF COQUITLAM STANDARD DRAWING COO-S16.
- INSPECTION CHAMBERS SHALL BE INSTALLED FOR ALL CONNECTIONS AS PER MMCD STANDARD DRAWING S9.
- SANITARY CONNECTION TO BE 100mmØ PVC UNLESS OTHERWISE NOTED
- TRENCHING SHALL BE AS PER CITY OF COQUITLAM STANDARD DRAWING COO-G4.
- ALL WYES TO BE MANUFACTURED.
- TIE INTO EXISTING SEWERS TO BE PERFORMED BY CONTRACTOR AND WITNESSED BY THE MUNICIPAL INSPECTOR. 48 HOURS NOTICE REQUIRED.
- ALL MANHOLES TO BE 1050Ø UNLESS OTHERWISE NOTED.

The seal and signature of the undersigned on this drawing certifies that the design information contained in this drawing accurately reflects the original design and the material changes made during construction that were brought to the undersigned's attention. This drawing is intended to incorporate addenda, change orders and other material design changes, but not necessarily all such instructions. The undersigned does not warrant or guarantee, nor accept liability responsibility for the accuracy or completeness of this as-constructed information supplied by others contained in this drawing, but does, by sealing and signing, certify that the as-constructed information, if satisfactory and complete, provides an as-constructed system which substantially complies in all material respects with the original design intent.

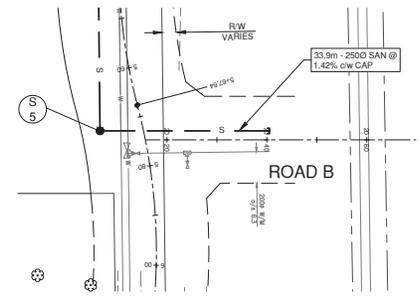

ROAD B SANITARY SEWER
1:500 HORIZ
1:50 VERT.

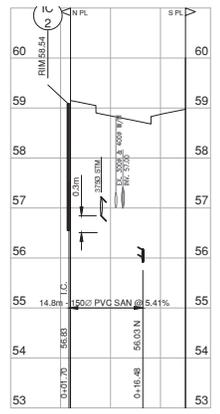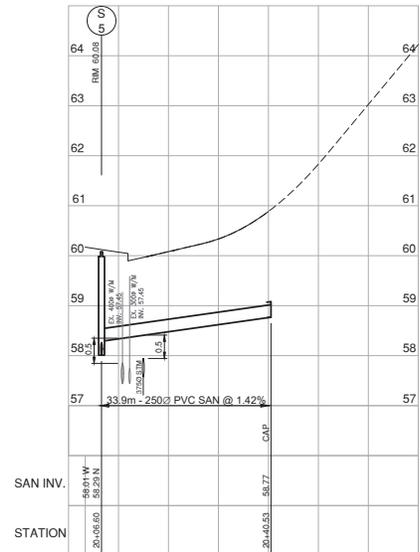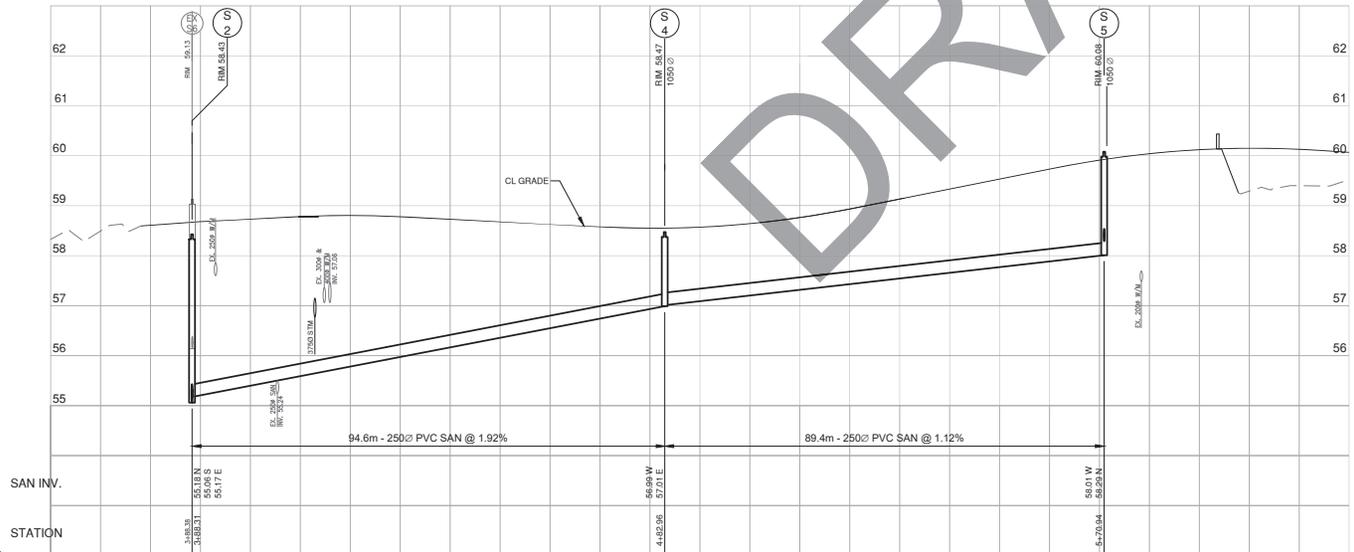

SANITARY CONNECTION
1:500 HORIZ
1:50 VERT.

NOTES:
1. SEE SHEET #2 FOR GENERAL NOTES.

LEGAL DESCRIPTION
LOTS 15616 PLAN 22154, AND LOTS 1306131 PLAN 67085; ALL OF SECTION 7, TOWNSHIP 40, N.W.D.

BENCHMARK
SURVEY MONUMENT #77H4134, INTERSECTION OF ROCKLIN STREET AND BAYCEST AVENUE
E.L. = 53.256M

Edge of pavement	Hydrant	Sanitary service	Hydro Guy Wire
Watermain and valve	Water air valve	Sanitary cleanout	Hydro Hoist
Drainage sewer, MH	Water blowoff	Utility pole/point pole	Vegetation Center
Drainage ditch	Water service	Utility pole with light	Vegetation Deciduous
Sanitary sewer, MH	Catch basin, top inlet	Streetlight, dual	Vegetation Shrub
Sanitary forcemain	Catch basin, side inlet	Streetlight, post top	Survey Traverse Hub
Gasmain and valve	Catch basin, round	Comb signal pole	Survey Iron Pin
Hydro duct, MH	Drainage service	Traffic signal pole	Survey Level Plug
Telephone duct, MH	Drainage cleanout	Junction box	Survey Monument

1	2021-06-06	S.U.	RECORD DRAWING
2	2020-06-02	B.D.	ROAD B REVISED
3	2020-03-06	B.D.	ISSUED FOR CONSTRUCTION
4	2020-01-21	B.D.	RE-ISSUED FOR SERVICING AGREEMENT
5	2019-12-12	B.D.	RE-ISSUED FOR SERVICING AGREEMENT
6	2019-11-01	B.D.	ISSUED FOR SERVICING AGREEMENT
7	2019-08-15	B.D.	RE-ISSUED FOR CITY REVIEW
No.	Date	By	Revisions


Design by: Date: **WSP**
 DUR: SEPT 2018
 Drawn by: Date: **WSP CANADA INC.**
 BDI: SEPT 2018
 Checked by: Date: **400-46 RICHMOND STREET**
 BDI: APR 2019
 Approved by: Date: **NEW WESTMINSTER, B.C.**
CHINA, V.A. 3P5
 TEL: 604-681-1144 FAX: 604-226-5710
 www.wsp.ca

ACCEPTED FOR CONSTRUCTION
 Date: _____
 Manager of Development Servicing

Coquitlam
 Engineering & Public Works
 3000 Guildford Way, Coquitlam, B.C. V3B 7N2



Scale: **1:500** Scale: **1:50**
 horiz. vert.
 Sheet: **11 of 23**
 Eng. Project No: **16-110057 SD**

Project: **MITCHELL TOWNHOMES**
 Description: **SANITARY SEWER GISLASON AVENUE & ROAD B**

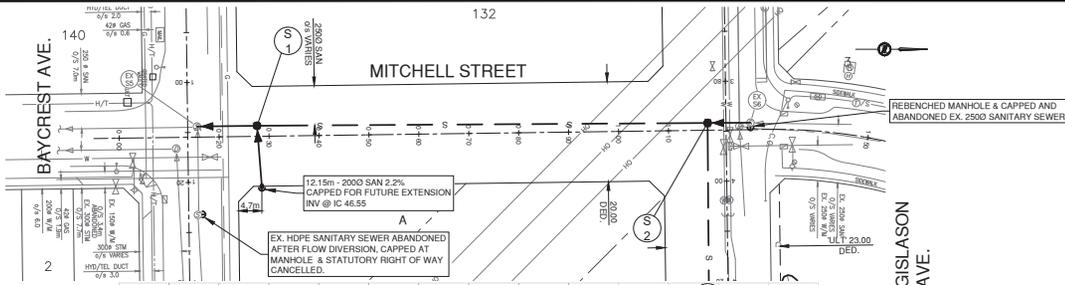


SANITARY SEWER

- UNLESS OTHERWISE INDICATED SANITARY SEWER MATERIALS SHALL BE:
 - MAINS: PVC DR 35
 - SERVICE CONNECTIONS: 100mmØ AND 150mmØ - PVC DR 28
 - 200mmØ AND GREATER - PVC DR 35
 - MANHOLES: 1050mmØ - PRECAST REINFORCED CONCRETE
- MANHOLES SHALL BE INSTALLED AS PER MMCD STANDARD DRAWING S1 AND S2. BENCHING SHALL BE AS PER MMCD STANDARD DRAWING S3. MANHOLE FRAMES AND COVERS SHALL CONFORM TO CITY OF COQUITLAM STANDARD DRAWING COQ-S16.
- INSPECTION CHAMBERS SHALL BE INSTALLED FOR ALL CONNECTIONS AS PER MMCD STANDARD DRAWING S9.
- SANITARY CONNECTION TO BE 100mmØ PVC UNLESS OTHERWISE NOTED
- TRENCHING SHALL BE AS PER CITY OF COQUITLAM STANDARD DRAWING COQ-G4.
- ALL WYES TO BE MANUFACTURED.
- TIE INTO EXISTING SEWERS TO BE PERFORMED BY CONTRACTOR AND WITNESSED BY THE MUNICIPAL INSPECTOR. 48 HOURS NOTICE REQUIRED.
- ALL MANHOLES TO BE 1050Ø UNLESS OTHERWISE NOTED.

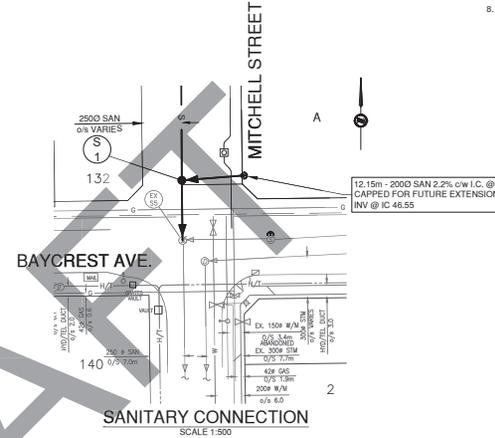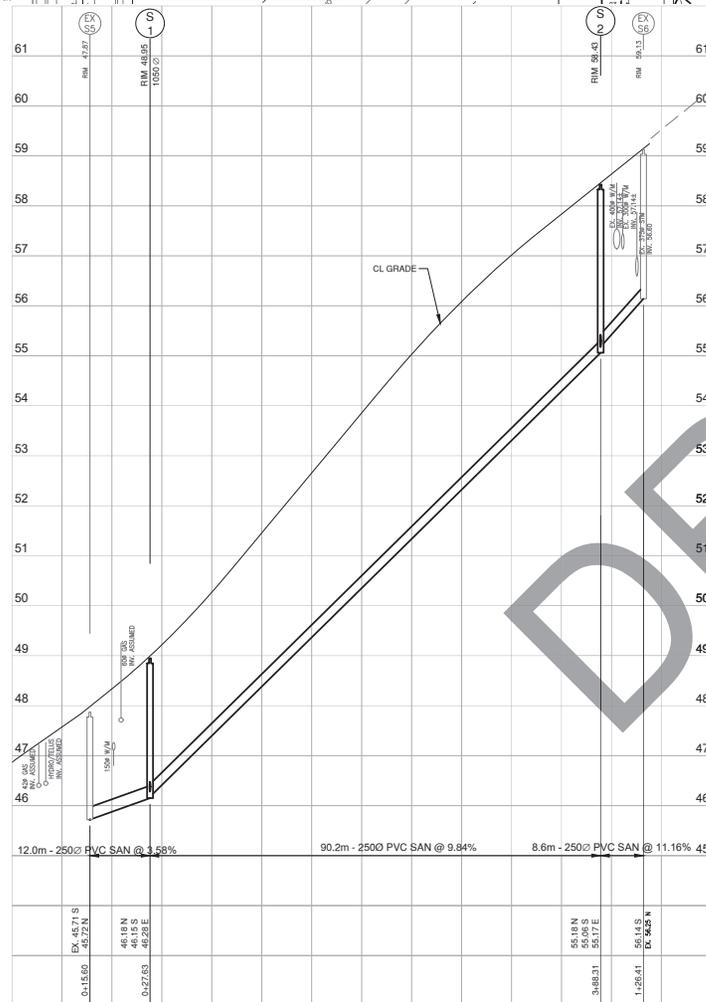

SANITARY CONNECTION

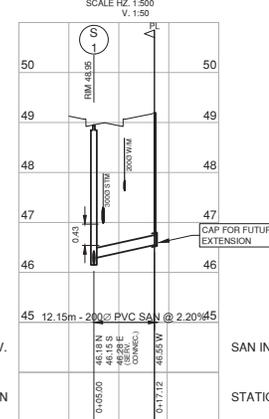


The seal and signature of the undersigned on this drawing certifies that the design information contained in this drawing accurately reflects the original design and the material design changes made during construction, that were brought to the undersigned's attention. This drawing is intended to incorporate addenda, change orders and other material design changes, but not necessarily all site instructions. The undersigned does not warrant or guarantee, nor accept any responsibility for the accuracy or completeness of the as-constructed information supplied by others contained in this drawing, but does, by sealing and signing, certify that the as-constructed information, if accurate and complete, provides an as-constructed system which substantially complies in all material respects with the original design intent.

NOTES:
1. SEE SHEET #2 FOR GENERAL NOTES.

LEGAL DESCRIPTION
LOTS 15&16 PLAN 22154, AND LOTS 130&131 PLAN 67085; ALL OF SECTION 7, TOWNSHIP 40, N.W.D.

BENCHMARK
SURVEY MONUMENT #774434, INTERSECTION OF ROCKLIN STREET AND BAYCREST AVENUE
E.L. = 53.258m

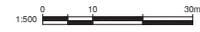

Edge of pavement	Hydrant	Sanitary service	Hydro Guy Wire
Watermain and valve	Water air valve	Sanitary cleanout	Hydro Risk
Drainage sewer, MH	Water blowoff	Utility pole (point pole)	Vegetation Center
Drainage ditch	Water service	Utility pole with light	Vegetation Deciduous
Sanitary sewer, MH	Catch basin, top inlet	Streetlight, dim	Vegetation Shrub
Sanitary forcemain	Catch basin, side inlet	Streetlight, post top	Survey Traverse Hub
Gasmain and valve	Catch basin, round	Comb signal pole	Survey Iron Pin
Hydro duct, MH	Drainage service	Traffic signal pole	Survey Level Plug
Telephone duct, MH	Drainage cleanout	Junction box	Survey Monument

H	2021-05-06	S	U	RECORD DRAWING
G	2020-03-06	B	D	ISSUED FOR CONSTRUCTION
F	2020-01-21	B	D	RE-ISSUED FOR SERVICING AGREEMENT
E	2019-12-12	B	D	RE-ISSUED FOR SERVICING AGREEMENT
D	2019-11-01	B	D	ISSUED FOR SERVICING AGREEMENT
C	2019-08-15	B	D	RE-ISSUED FOR CITY REVIEW
B	2019-04-11	B	D	RE-ISSUED FOR CITY REVIEW
No.	Date	By	Revisions	

Design by: Date: SEP 2018
 Drawn by: Date: SEPT 2018
 Checked by: Date: APR 2019
 Approved by: Date:

ACCEPTED FOR CONSTRUCTION
 Date: _____
 Manager of Development Servicing

Scale: 1:500
 Scale: 1:50
 Sheet: 12 of 23
 Eng. Project No: 16-110057 SD

Project: MITCHELL TOWNHOMES
 Description: SANITARY SEWER MITCHELL STREET